


VOID

STATE	PROJECT NUMBER	SHEET NO.	TOTAL SHEETS
GA.	NH000-0017-01(022)	213	333

BENT 2	
LOCATION	BOTTOM OF FOOTING ELEVATION
COLUMN 1	
COLUMN 2	
COLUMN 3	

BENT 3	
LOCATION	BOTTOM OF FOOTING ELEVATION
COLUMN 1	
COLUMN 2	
COLUMN 3	

BENT 4	
LOCATION	BOTTOM OF FOOTING ELEVATION
COLUMN 1	
COLUMN 2	
COLUMN 3	

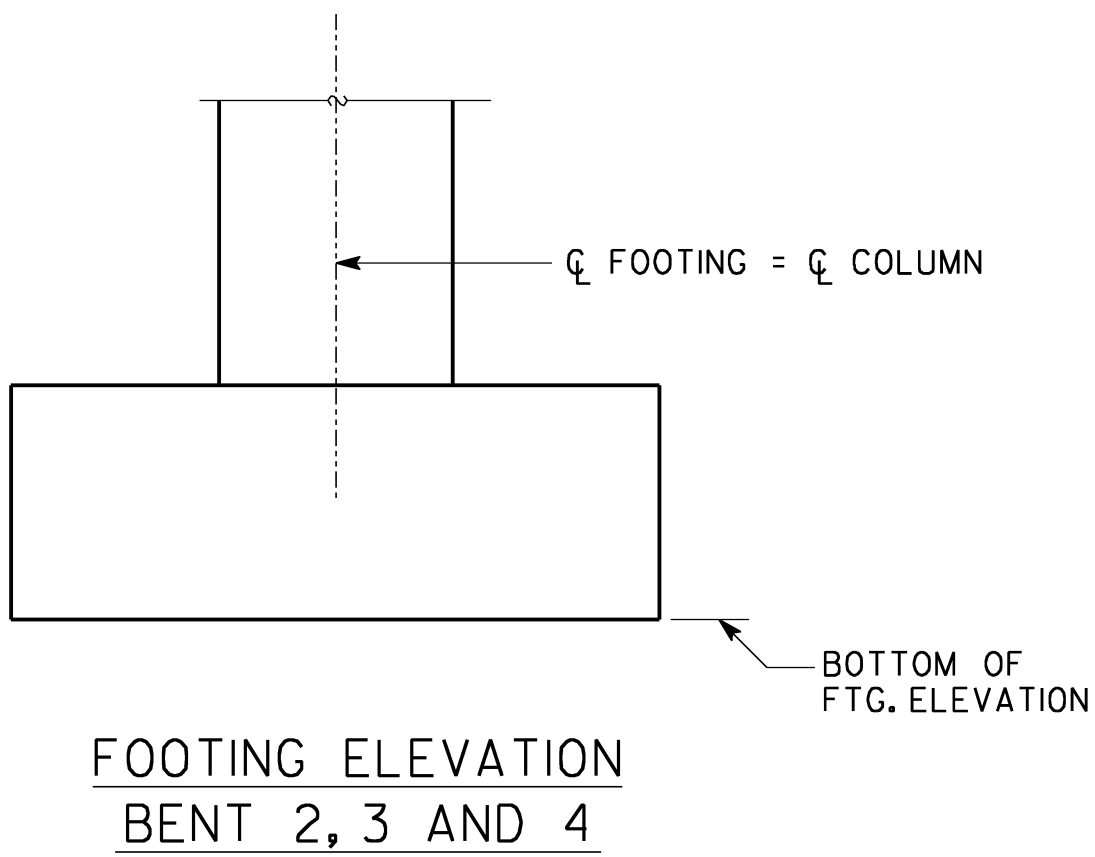

THIS SHEET IS TO BE FILLED IN BY THE PROJECT ENGINEER AND FORWARDED TO THE BRIDGE DESIGN OFFICE AFTER INSTALLATION OF FOOTINGS FOR POSTING TO THE PLANS AS A PERMANENT RECORD OF THE BRIDGE CONSTRUCTION.

PROJECT ENGINEER

DATE

()
(AREA CODE)

TELEPHONE NUMBER

BRIDGE NO. 1LT. & RT.

AECOM

GEORGIA
DEPARTMENT OF TRANSPORTATION
PRECONSTRUCTION DIVISION-OFFICE OF BRIDGE DESIGN

AS-BUILT FOUNDATION
WIDENING SR 1/US 27 OVER SR 166

CARROLL COUNTY

NH000-0017-01(022)

SCALE: NO SCALE U.N.O.

MARCH 2011

DRAWING NO.
35- 17

BRIDGE SHEET
17 OF 18

REVISIONS	DATE			
	BY			

DESIGNED	LS	CHECKED	GLE	REVIEWED	WMD/WEI
DRAWN	LS	GOOT LIAISON	CB	APPROVED	BFR